


断面 E-E 詳細 S 1/20

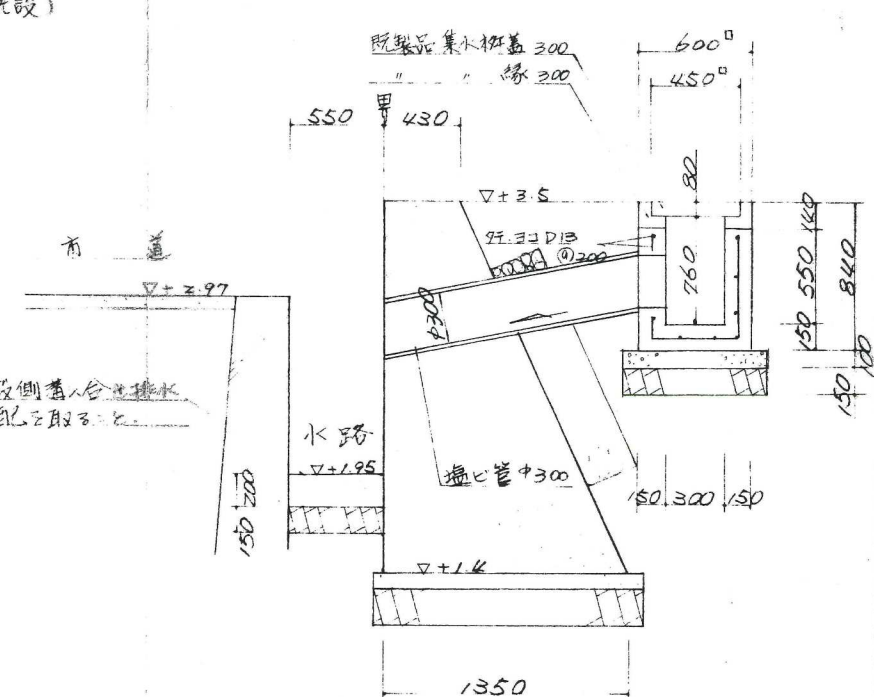

① 部断面詳細 S 1/30

竣工図