




# 工事竣工図

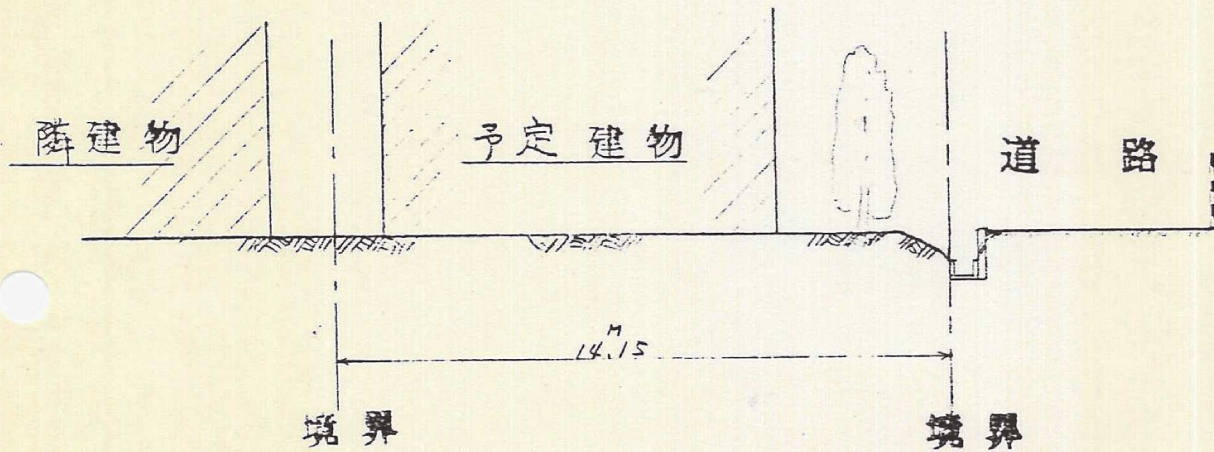

A~A' 断面図 S:1/200

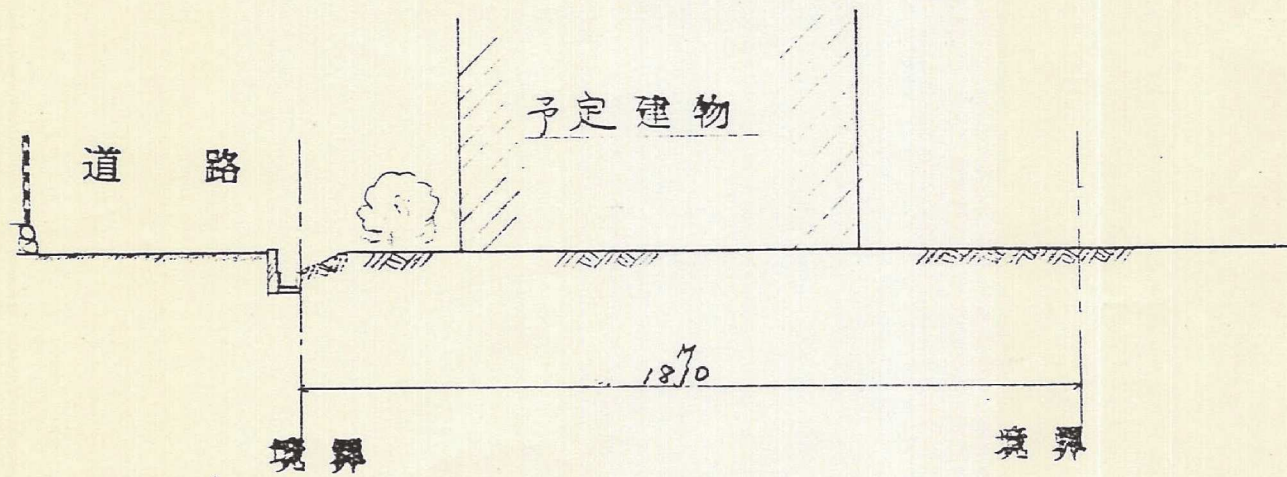

B~B' 断面図 S:1/200

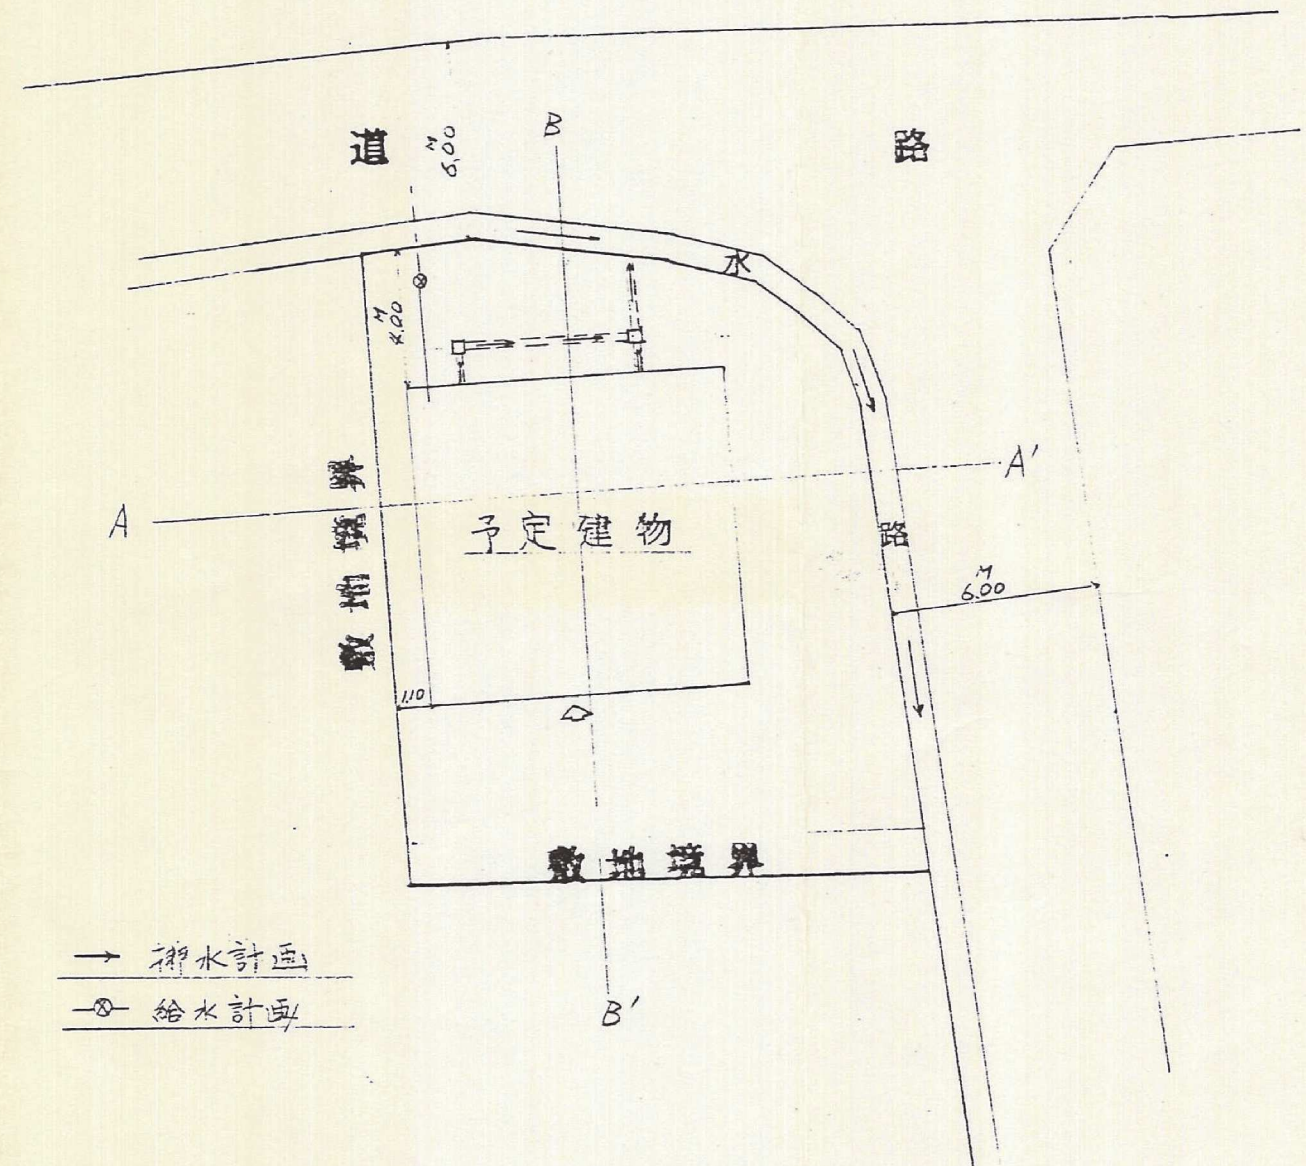

平面図・配置図 S:1/250

60-7