
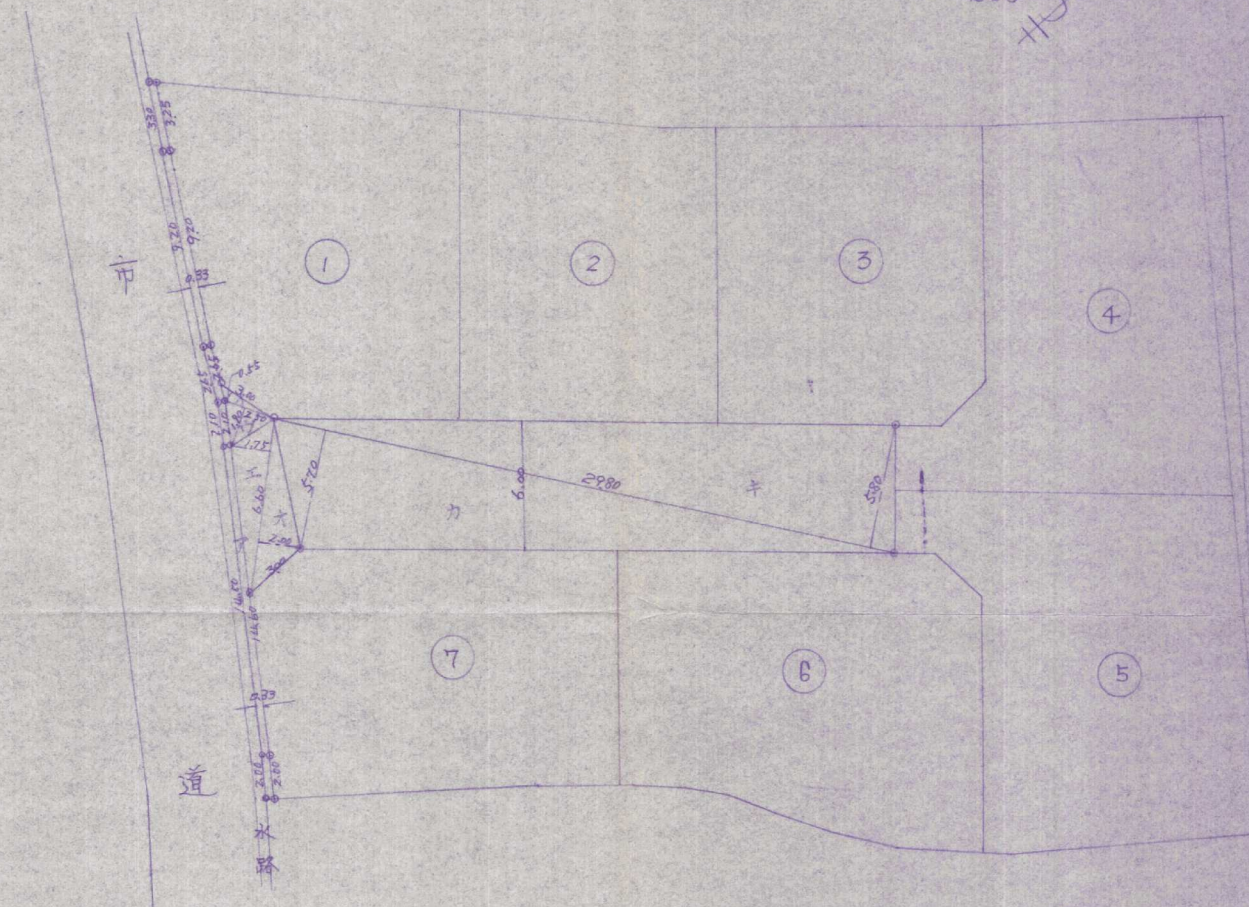


竣工平面図

$$S = \frac{1}{250}$$

公共施設求積図

$$S = \frac{1}{250}$$

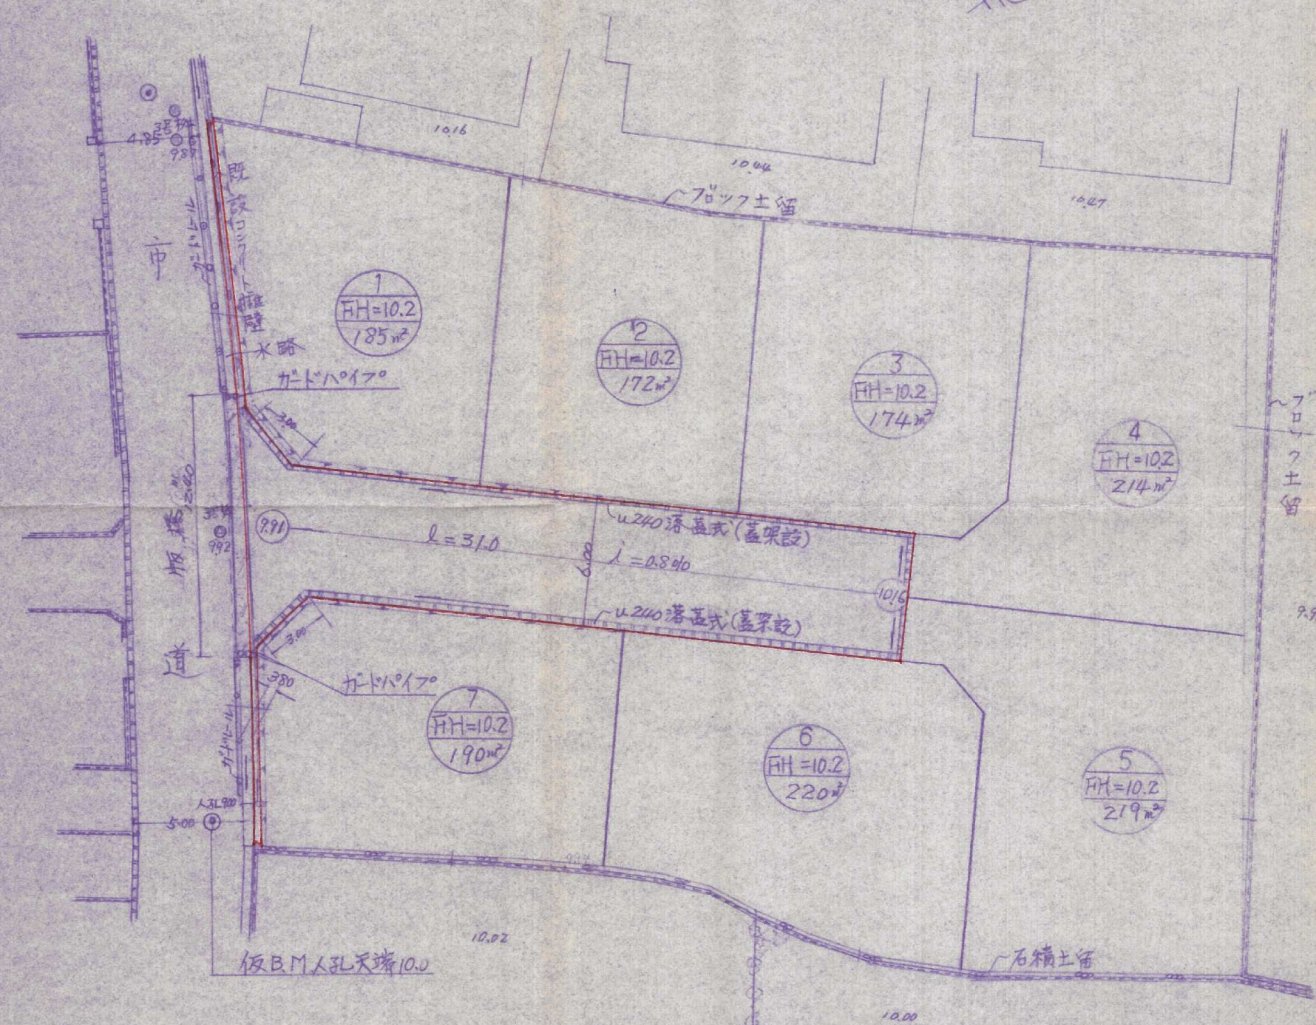

求積表

ア	$(2.00+14.50+2.10+2.65+9.20+3.30+2.40+14.60+2.10+2.65+9.20+3.25) \times 0.33$			22.2915
イ	3.00	X	0.55	1.65
ロ	2.50	X	1.90	4.75
ハ	6.60	X	1.75	11.55
ニ	6.60	X	2.00	13.20
ホ	29.80	X	5.70	169.86
ヘ	21.80	X	5.80	126.84
計				396.1415
1/2				198.0707

$$\therefore 198.07 \text{ m}^2$$

工事名称	図面内容	縮尺	日付	検修	図面番号
		S =			NO.