


竣工平面图 $S = \frac{1}{250}$

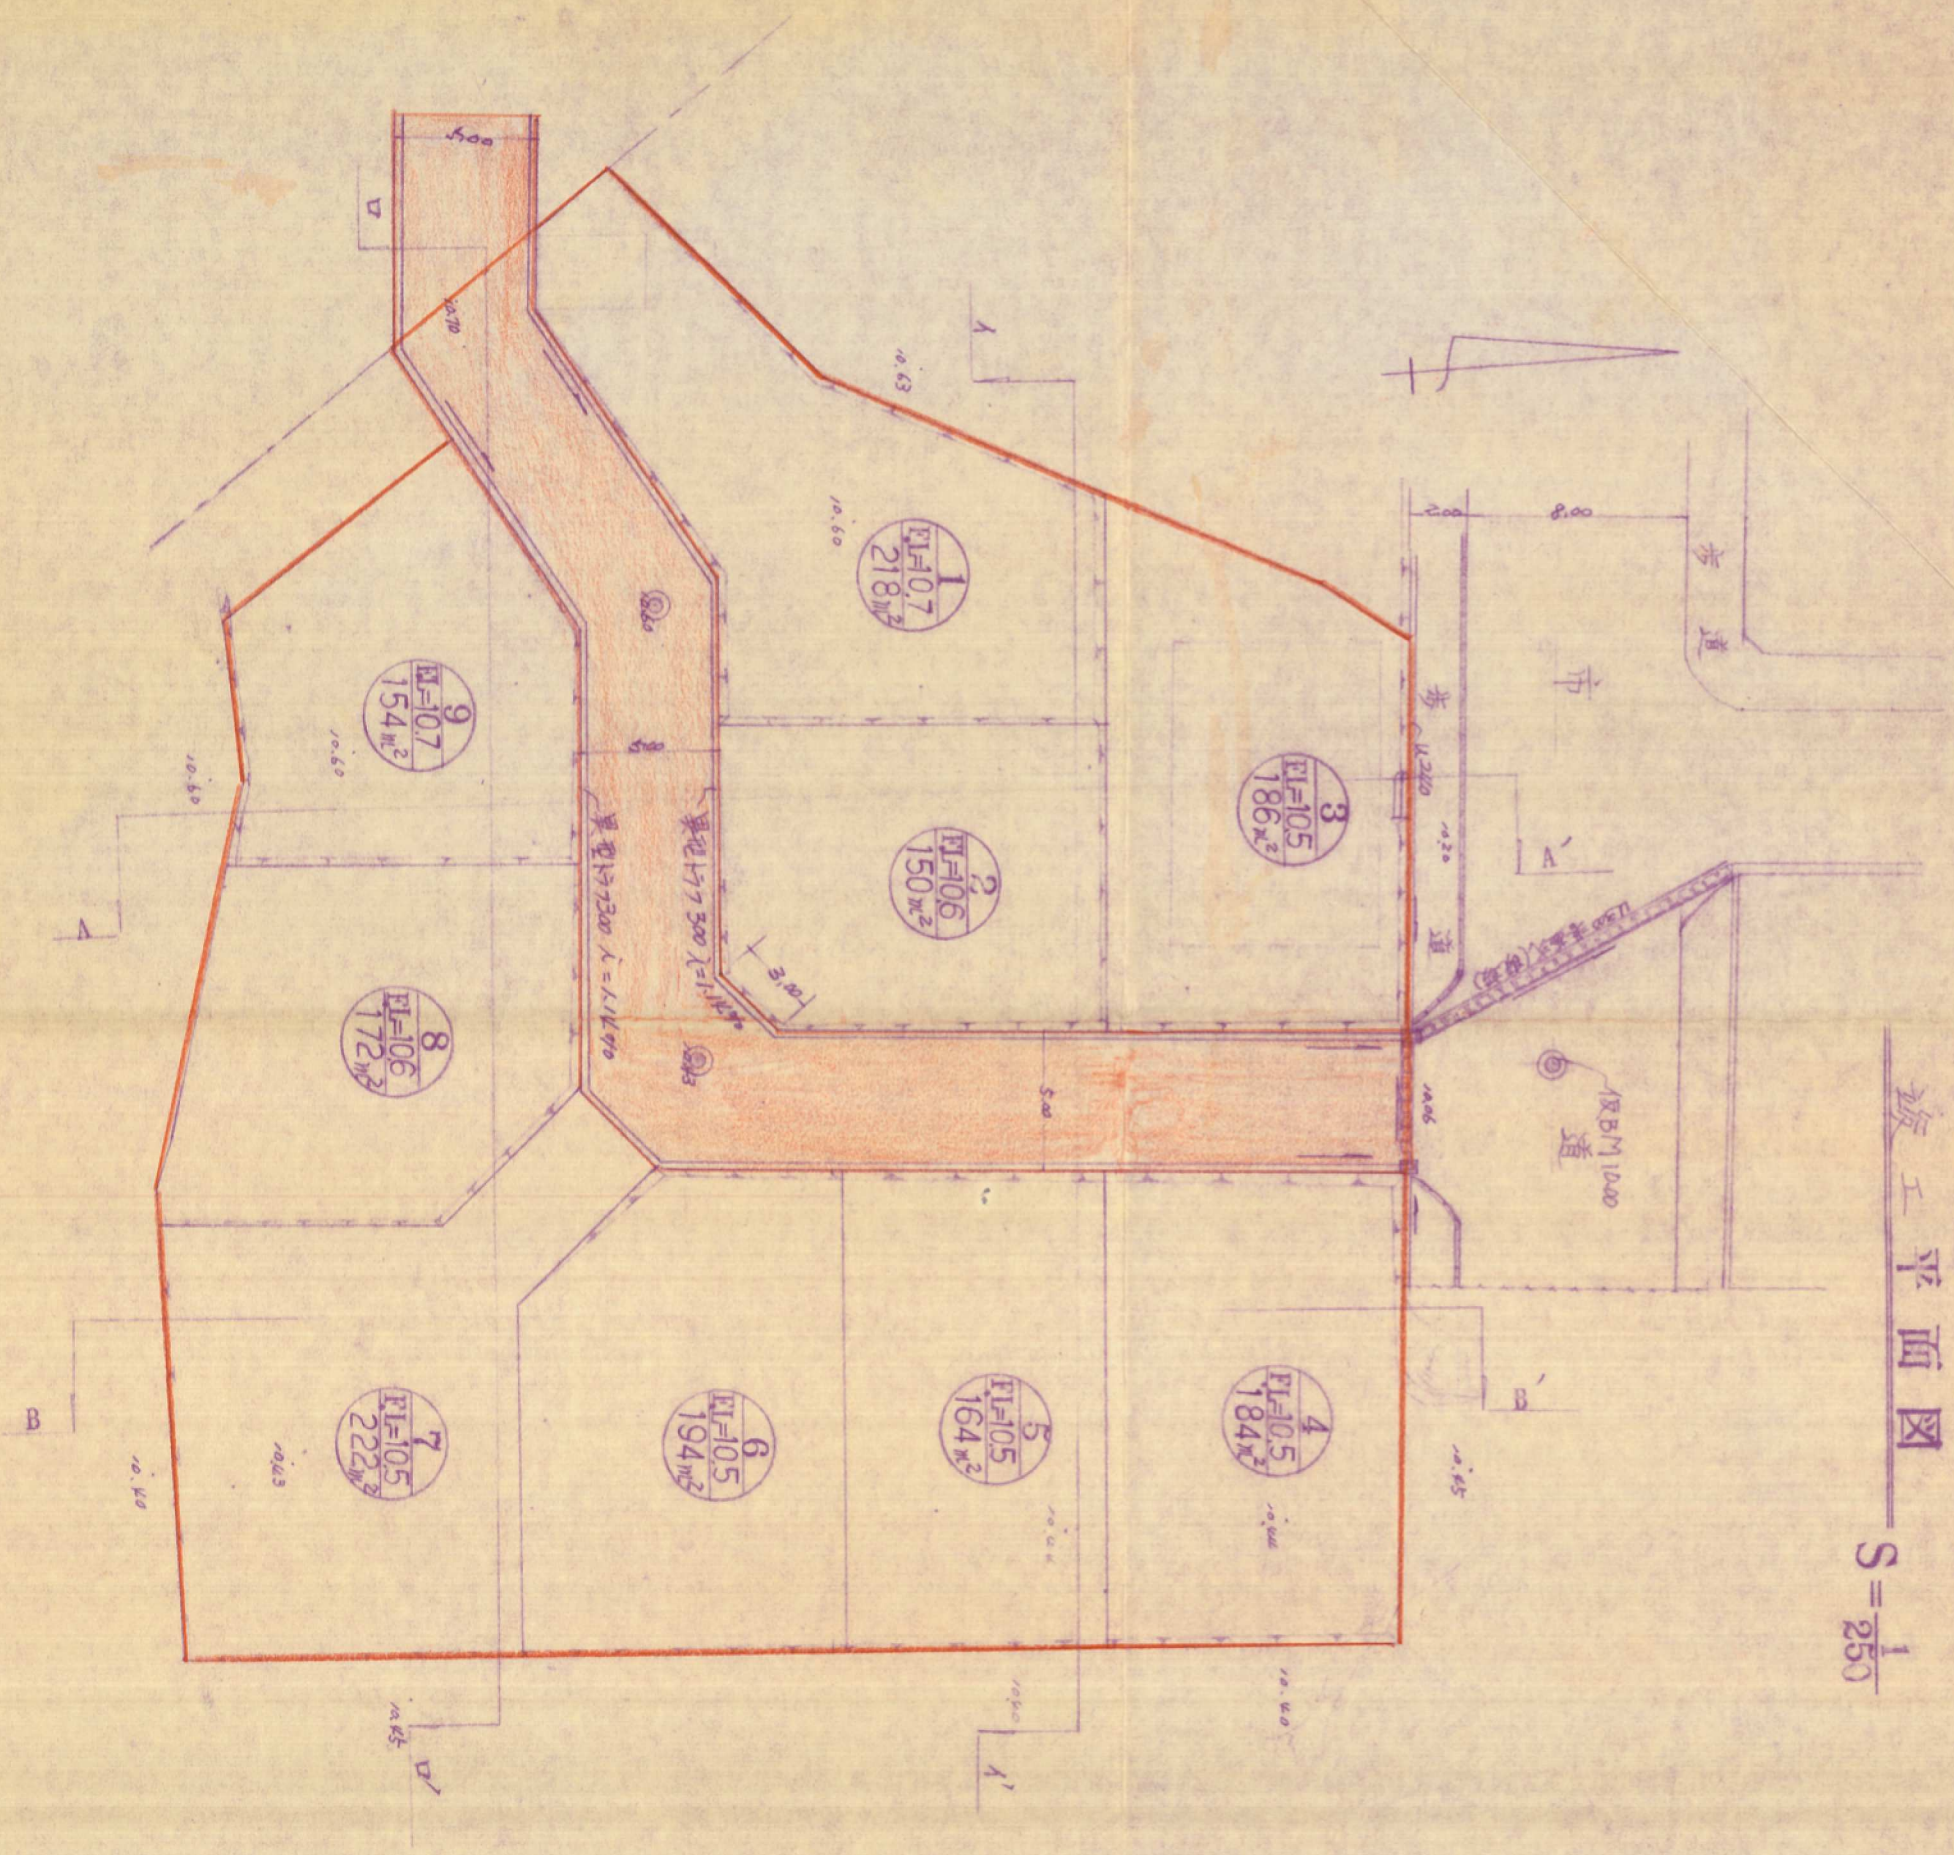

57-63